



Drawing Notes:
Legacy Monument sign: Quantity (1)


RDG
301 Grand Avenue
Des Moines, Iowa 50339
www.rdg.com

APPROVED
 APPROVED AS NOTED
 REVISE AND RESUBMIT
 REJECTED
 SUBMIT SPECIFIC ITEM



IF APPROVED or APPROVED AS NOTED fabrication MAY be undertaken. Action shown above does not relieve the contractor from compliance with the contract documents.

IF REVISE AND RESUBMIT, REJECTED or SUBMIT SPECIFIC ITEM fabrication MAY NOT be undertaken. Resident corrected copies for final review. On resubmission, Contractor shall specifically identify all changes other than those noted by the Architect on the previous submittal. This review is only for general conformance with the design concept and the information given in the Construction Documents. Approval of a specific item shall not be construed as approval of any assembly of which the item is a component. Corrections or omissions made on the shop drawings during this review do not relieve the contractor from compliance with the requirements of the plans and specifications and applicable laws, codes and regulations. The contractor is responsible for quantities and dimensions to be confirmed and controlled at the jobsite; information that pertains solely to the fabrication processes or to the means, methods, techniques, sequences and procedures of construction; coordination of the work with that of all other trades; and performing all work in a safe and satisfactory manner.

DATE: 8/15/2016 BY: [Signature]
SUBMITTAL: PROJECT: AMES LAB

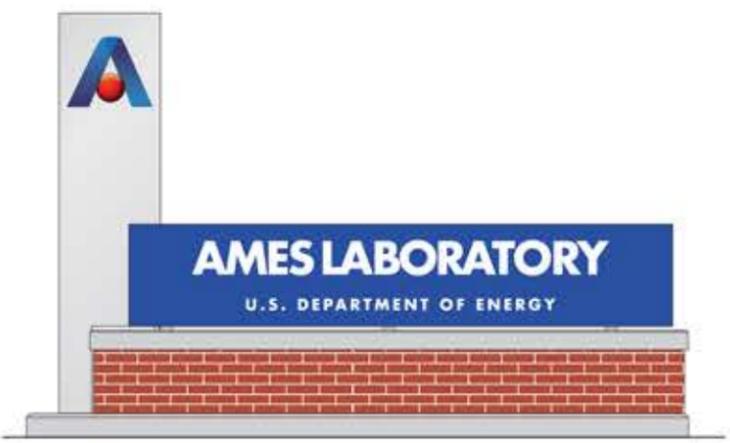

03 SIDE B ELEVATION VIEW
scale: 1/4"=1'

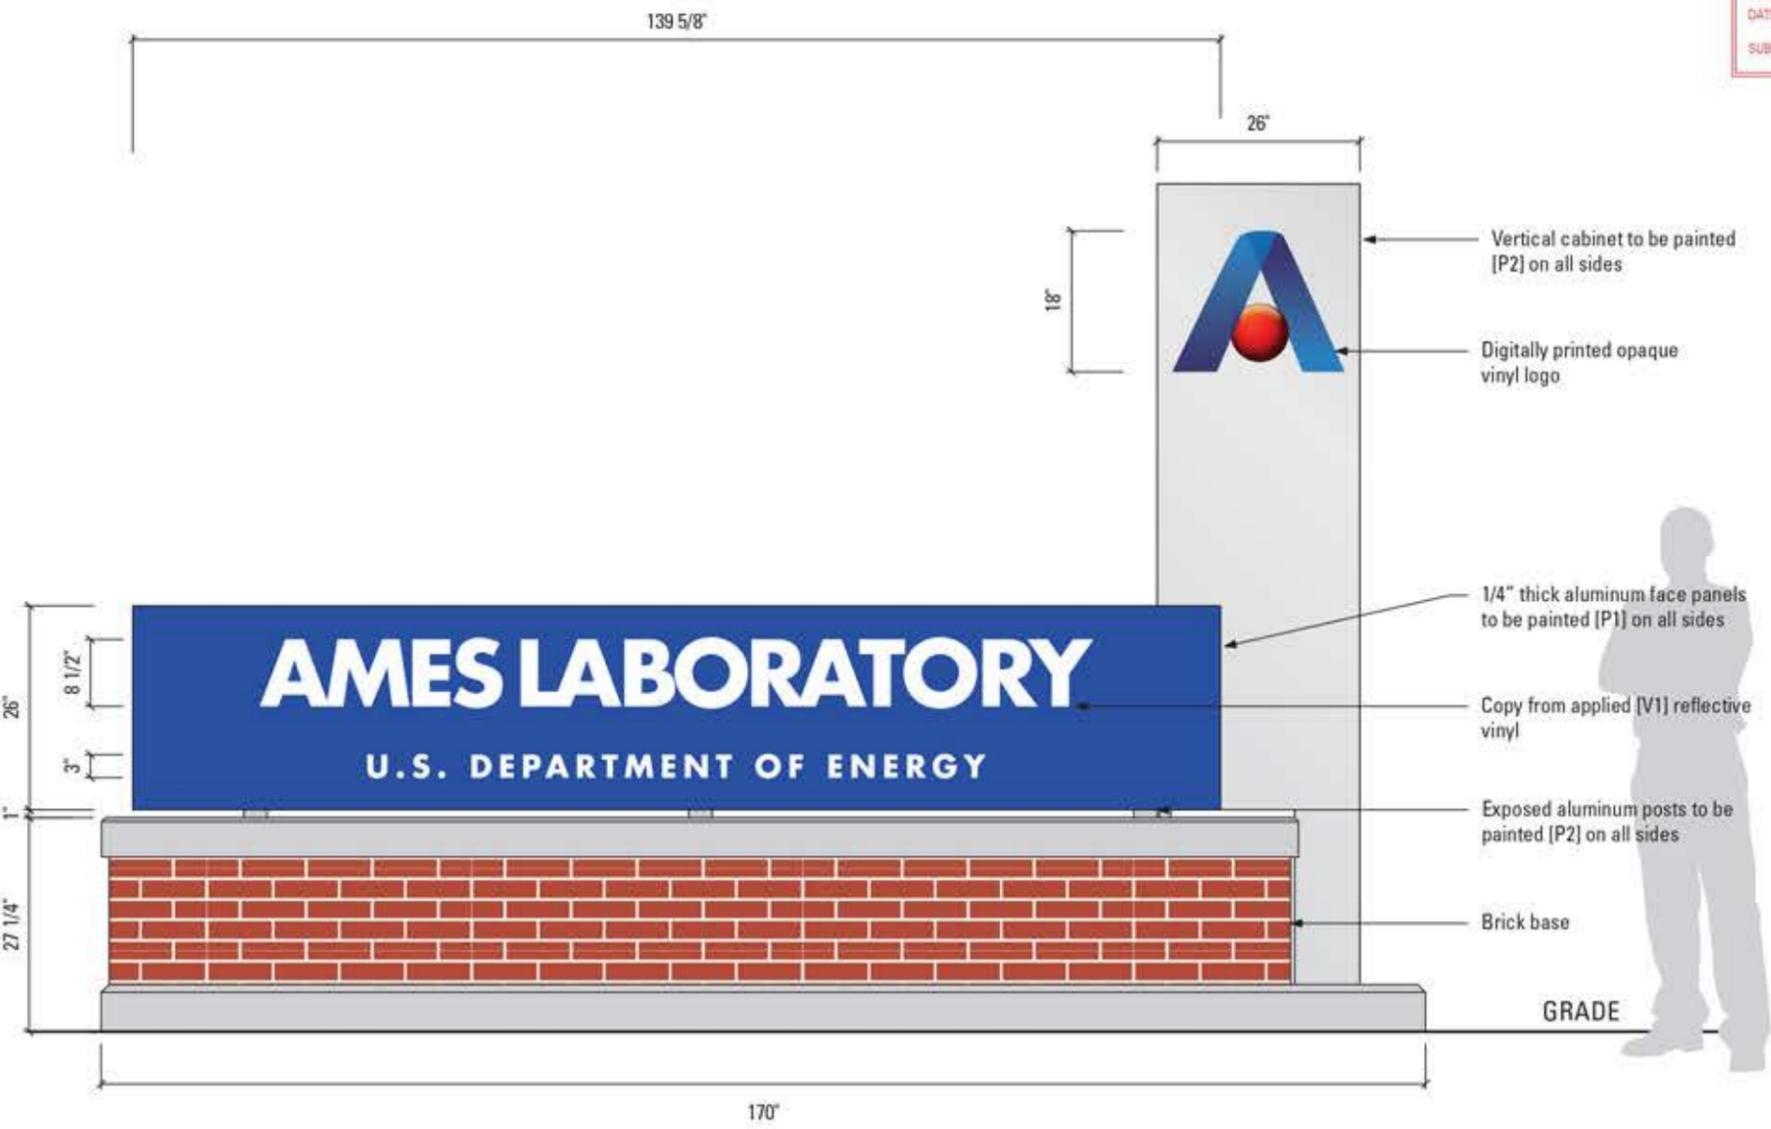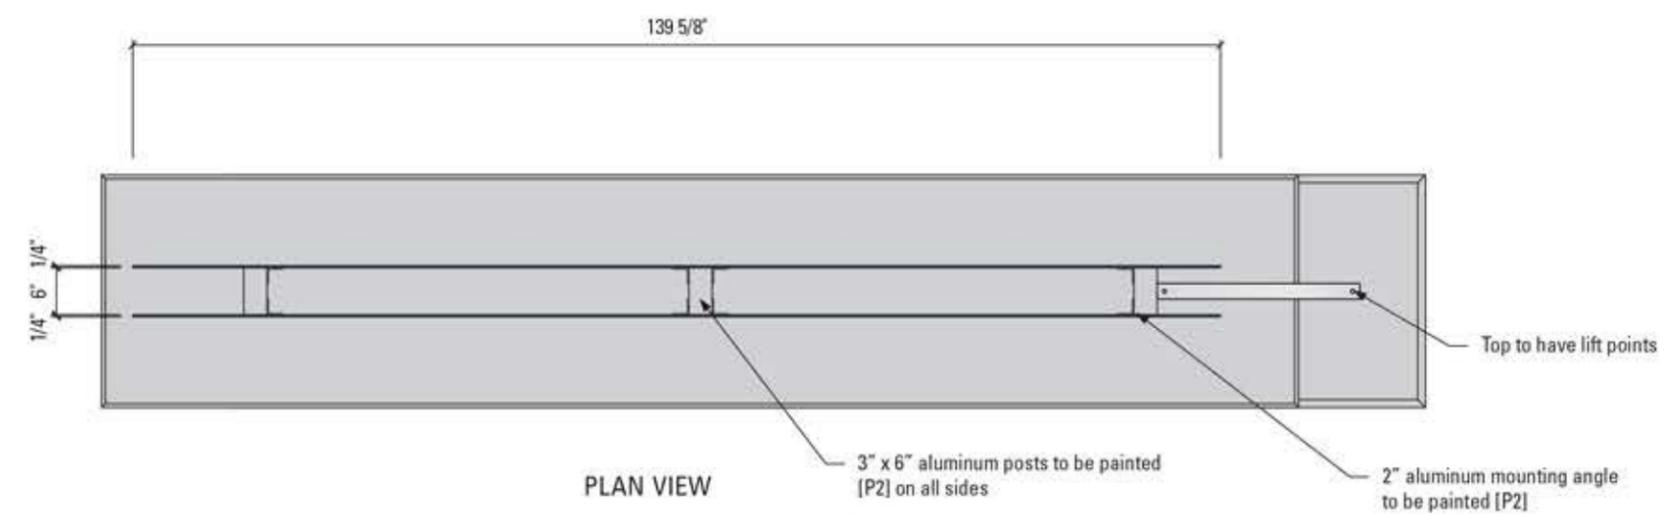

01 SIDE A ELEVATION VIEW
scale: 1/2"=1'

- [V1] 280-10 Reflective White
- [V2] 220-12 Opaque Black
- [P1] MX-66 Cobalt
- [P2] SC-913 Flint


Sign Type: E1
 Description: Primary Sign
 Scale: Noted
 Project: Exterior Signage
 Client: Ames Laboratory
 Date: 07/26/16 By: RMH

Revision	Description	Date
*	*	*

This drawing is exclusive property of ASI Signage Innovations and may not be handed over, copied or used by third parties. ©2011 Colors represented may not match the PMS chip, vinyl, or paint colors exactly. It is to be viewed as a color representation only.

DESIGN STATUS:
 Approved BY: _____
 Revise & resubmit DATE: _____

Client approval of this print is required prior to manufacturing. Your approval acknowledges that this print is correct and supercedes all previous drawings and/or specifications related to this order.

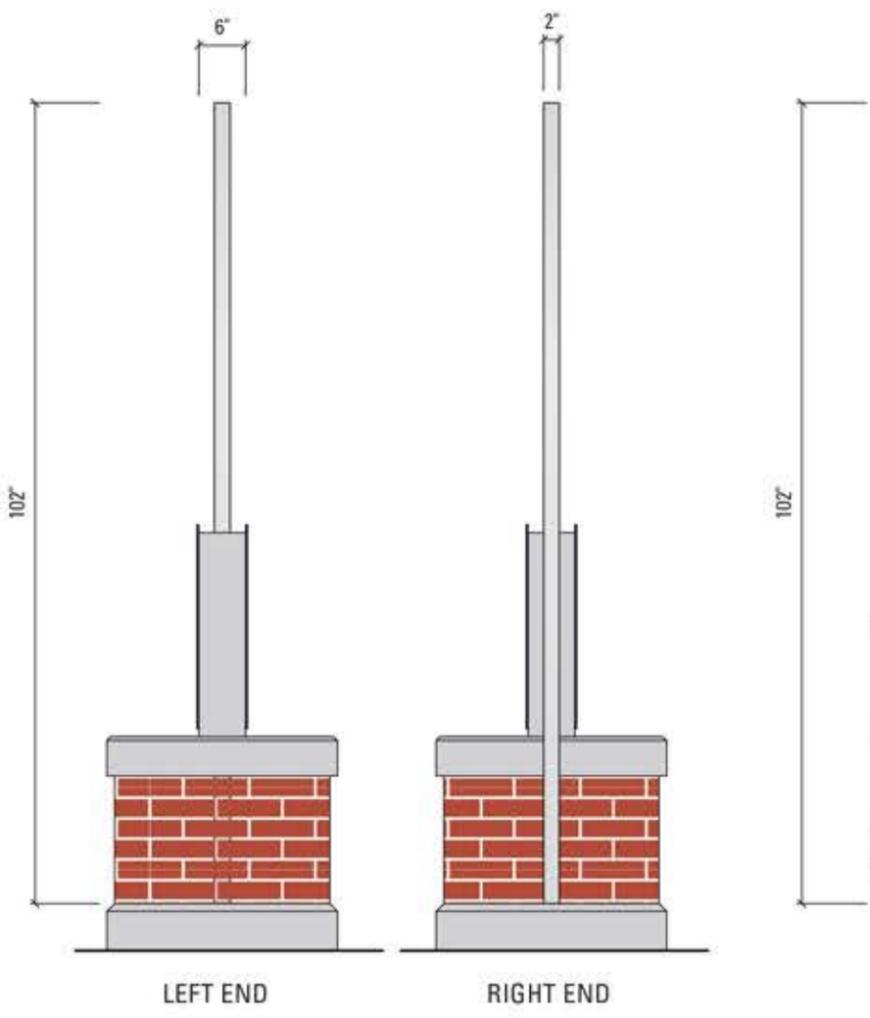

02 END VIEWS
scale: 1/2"=1'